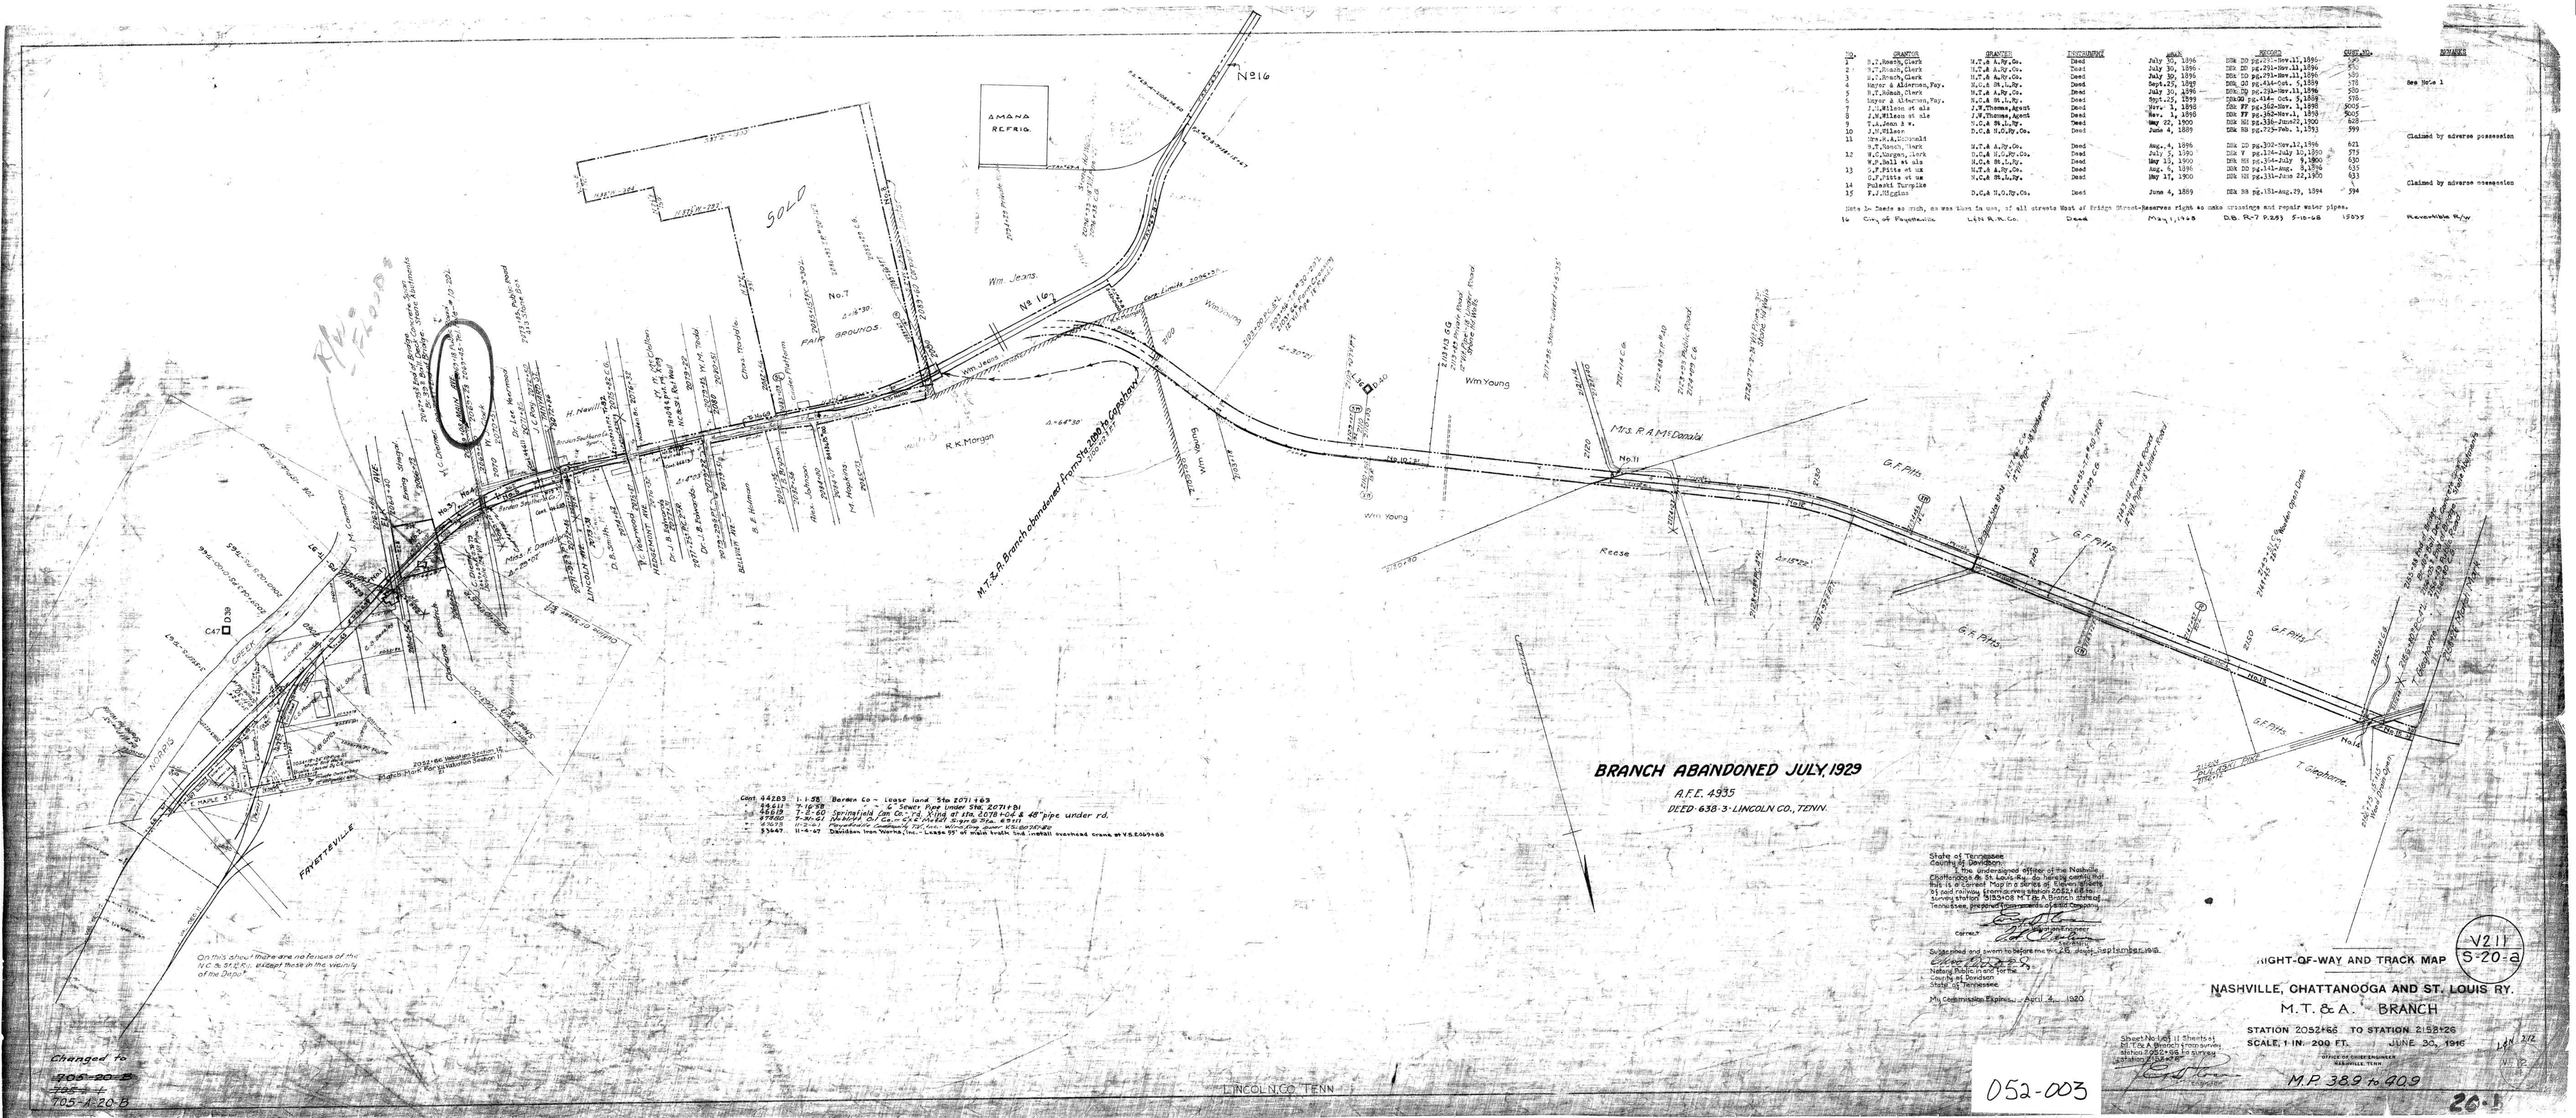

NO.	GRANTOR	GRANTEE	INSTRUMENT	DATE	RECORD	CUST. NO.	REMARKS
1	B.T.Roach, Clerk	M.T.& A.Ry.Co.	Deed	July 30, 1896	DBk DD pg.291-Nov.11,1896	580	
2	B.T.Roach, Clerk	M.T.& A.Ry.Co.	Deed	July 30, 1896	DBk DD pg.291-Nov.11,1896	580	
3	B.T.Roach, Clerk	M.T.& A.Ry.Co.	Deed	July 30, 1896	DBk DD pg.291-Nov.11,1896	580	
4	Mayer & Alderman, Fay.	N.C.& St.L.Ry.	Deed	Sept.25, 1899	DBk QQ pg.414-Oct. 5,1899	578	See Note 1
5	B.T.Roach, Clerk	M.T.& A.Ry.Co.	Deed	July 30, 1896	DBk DD pg.291-Nov.11,1896	580	
6	Mayer & Alderman, Fay.	N.C.& St.L.Ry.	Deed	Sept.25, 1899	DBk QQ pg.414- Oct. 5,1899	578	
7	J.W.Wilson et als	J.W.Thomas, Agent	Deed	Nov. 1, 1898	DBk FF pg.362-Nov. 1,1898	5005	
8	J.W.Wilson et als	J.W.Thomas, Agent	Deed	Nov. 1, 1898	DBk FF pg.362-Nov.1, 1898	5005	
9	T.A.Jean & W.	N.C.& St.L.Ry.	Deed	May 22, 1900	DBk NN pg.336-June22,1900	628	
10	J.W.Wilson	D.C.& N.O.Ry.Co.	Deed	June 4, 1889	DBk BB pg.723-Feb. 1,1893	599	
11	Mrs.R.A.McDonald						Claimed by adverse possession
	B.T.Roach, Clerk	M.T.& A.Ry.Co.	Deed	Aug. 4, 1896	DBk DD pg.302-Nov.12,1896	621	
12	W.C.Morgan, Clerk	D.C.& N.O.Ry.Co.	Deed	July 5, 1890	DBk V pg.134-July 10,1890	575	
	W.P.Bell et als	N.C.& St.L.Ry.	Deed	May 15, 1900	DBk NN pg.364-July 9,1900	630	
13	G.F.Pitts et ux	M.T.& A.Ry.Co.	Deed	Aug. 6, 1896	DBk DD pg.141-Aug. 8,1896	635	
	G.F.Pitts et ux	N.C.& St.L.Ry.	Deed	May 17, 1900	DBk NN pg.331-June 22,1900	633	
14	Pulaski Turnpike						Claimed by adverse possession
15	F.J.Higgins	D.C.& N.O.Ry.Co.	Deed	June 4, 1889	DBk BB pg.181-Aug.29, 1894	594	

Note 1- Deeds so much, as was taken in use, of all streets West of Bridge Street-Reserves right to make crossings and repair water pipes.

16	City of Fayetteville	L&N R.R.Co.	Deed	May 1,1968	D.B. R-7 P.253 5-10-68	15035	Revertible R/W

Cont 44283 1-1-58 Barren Co - Lease land Sta 2071+63
" 44611 7-16-58 " " " 6" Sewer Pipe under Sta. 2071+81
" 46619 7-2-60 Springfield Can Co - rd. Xing at Sta. 2078+04 & 48" pipe under rd.
" 47880 7-31-61 Nashville G.I. Co. - C.&E. Metal Sign @ Sta. 2911
" 43678 11-3-61 Fayetteville Community Tel. Co. - wire Xing over K.S.L. 2075+82
" 53647 11-4-67 Davidson Iron Works, Inc. - Lease 55' of main track and install overhead crane at V.S.E. 2069+88

On this sheet there are no fences of the N.C.& St.L.R.R. except those in the vicinity of the Depot.

Changed to
~~705-20-B~~
~~705-A-20-B~~
705-A-20-B

BRANCH ABANDONED JULY, 1929

A.F.E. 4935
DEED-638-3-LINCOLN CO., TENN.

State of Tennessee
County of Davidson

"I, the undersigned officer of the Nashville Chattanooga & St. Louis Ry., do hereby certify that this is a Correct Map in a series of Eleven sheets of said railway from survey station 2052+66 to survey station 2133+08 M.T.& A. Branch state of Tennessee, prepared from records of said Company.

Correct
Division Engineer
Secretary

Subscribed and sworn to before me this 26 day of September 1919.

Notary Public in and for the
County of Davidson
State of Tennessee

My Commission Expires April 4, 1920

V211
S-20-a

RIGHT-OF-WAY AND TRACK MAP

NASHVILLE, CHATTANOOGA AND ST. LOUIS RY.

M.T.& A. BRANCH

STATION 2052+66 TO STATION 2158+26
SCALE, 1 IN. 200 FT. JUNE 30, 1916

Sheet No. 1 of 11 Sheets of M.T.& A. Branch from survey station 2052+66 to survey station 2158+26

OFFICE OF CHIEF ENGINEER
NASHVILLE, TENN.

M.P. 38.9 to 40.9

052-003

20-1